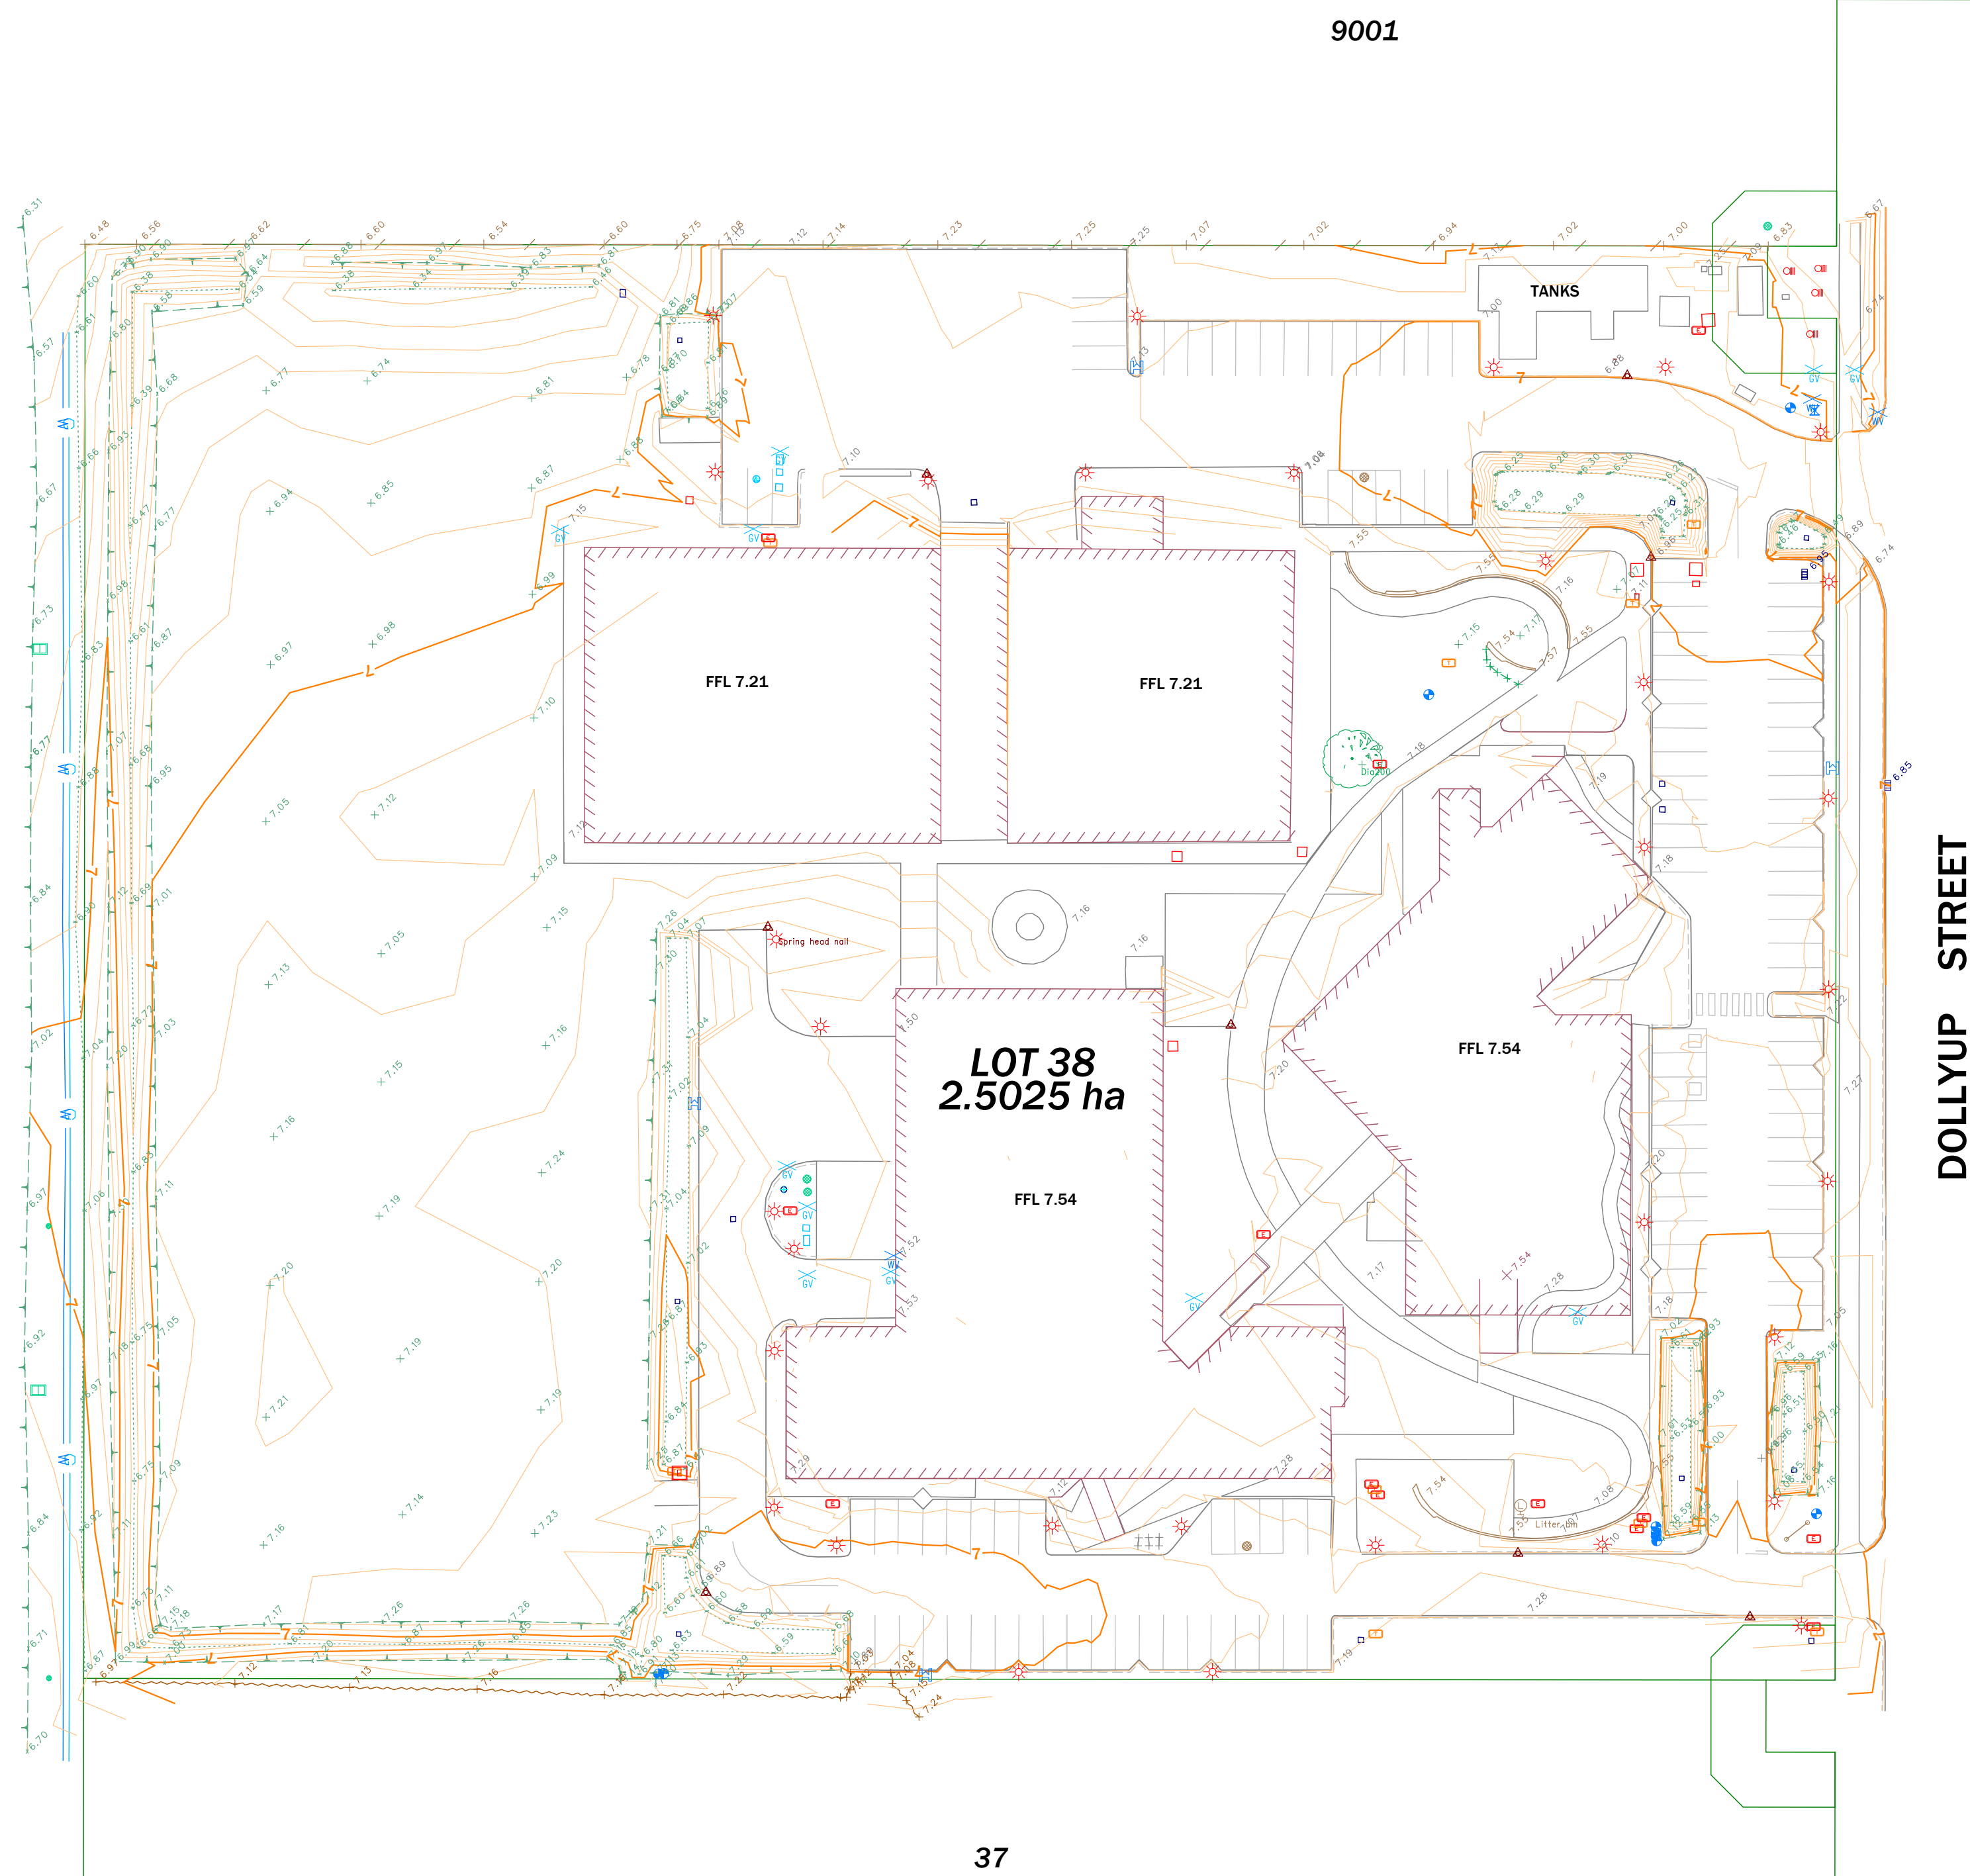


22 Brockman Street, Capel, WA 6271
T: 0427078797
E: bendobbe@inet.net.au

A	23-10-23	Original Drawing
REV	DATE	DETAILS

Surveyed	BD Sep 23
Drawn	BD 23-10-23
Datum	PCG 94 AHD
Scale	1:500 @ A1

Drawing	FIPWA-As-ConstructedSurveyV1
Cad File	
Client	

AS-CONSTRUCTED SURVEY
FIPWA, NAMBEELUP
SHIRE OF MURRAY